


Muskegon Lake - Heritage Landing
Shoreline Repair and Restoration
Muskegon County, Michigan

West Michigan Shoreline
Regional Development Commission

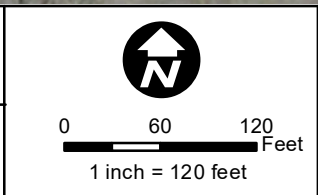

AS-BUILT

Project: 1902529 Figure: 1