


- This survey is referenced horizontally to the North American Datum of 1983, 2011 adjustment (NAD83/2011) and projected on the New York State Plane Coordinate System (West Zone), and vertically to the International Great Lakes Datum of 1985 (IGLD85).
- North arrow as shown indicates Grid North referenced to NAD83/2011 projected on the New York State Plane Coordinate System (West Zone).
- The reference horizontal and vertical control was provided by Terratek GPS Modeling.
- Contours shown hereon were generated from a Digital Terrain Model utilizing Autodesk Civil 3D Surveying and Engineering software.
- The topographic and planimetric information shown hereon was provided by Terratek GPS Modeling.

Legend:

- Major Contour
- Minor Contour
- Overhead Electric Transmission Lines
- Coir Log
- Edge of Mulch
- Project Limit
- Timber Log
- Slide Rock
- Spot Elevation and Location

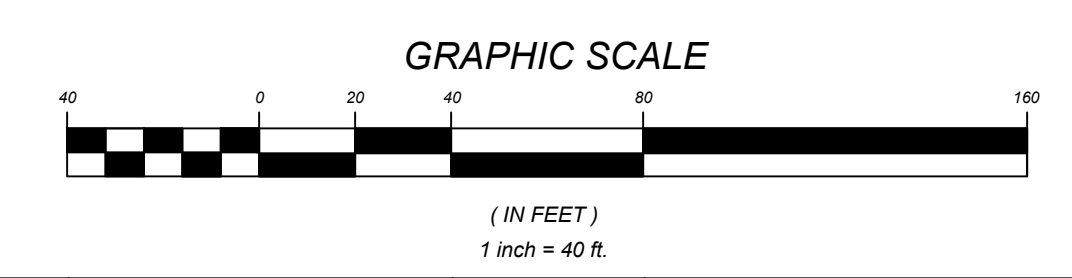

DRAWN: MRW		Map Showing As-Built Features Katherine Street Area Buffalo River Habitat Restoration City of Buffalo County of Erie State of New York
CHECKED: JST		
SCALE: 1" = 40'		Thew Associates LAND SURVEYORS www.TheAssociates.com <small>P.O. Box 463 6431 US Highway 11 Canastota, New York 13617 T: 315-286-2776 F: 315-286-1012</small>
DATE: 08-20-2018		
PROJECT NUMBER: CK3872-04-18	REV:	DESCRIPTION:

Unauthorized alteration or addition to a survey map bearing a licensed land surveyors seal is a violation of Section 7209, Subdivision 2 of the New York State Education Law.
 Only copies from the original of this survey marked with an original of the surveyor's inked seal or his embossed seal shall be considered to be valid and true copies.